


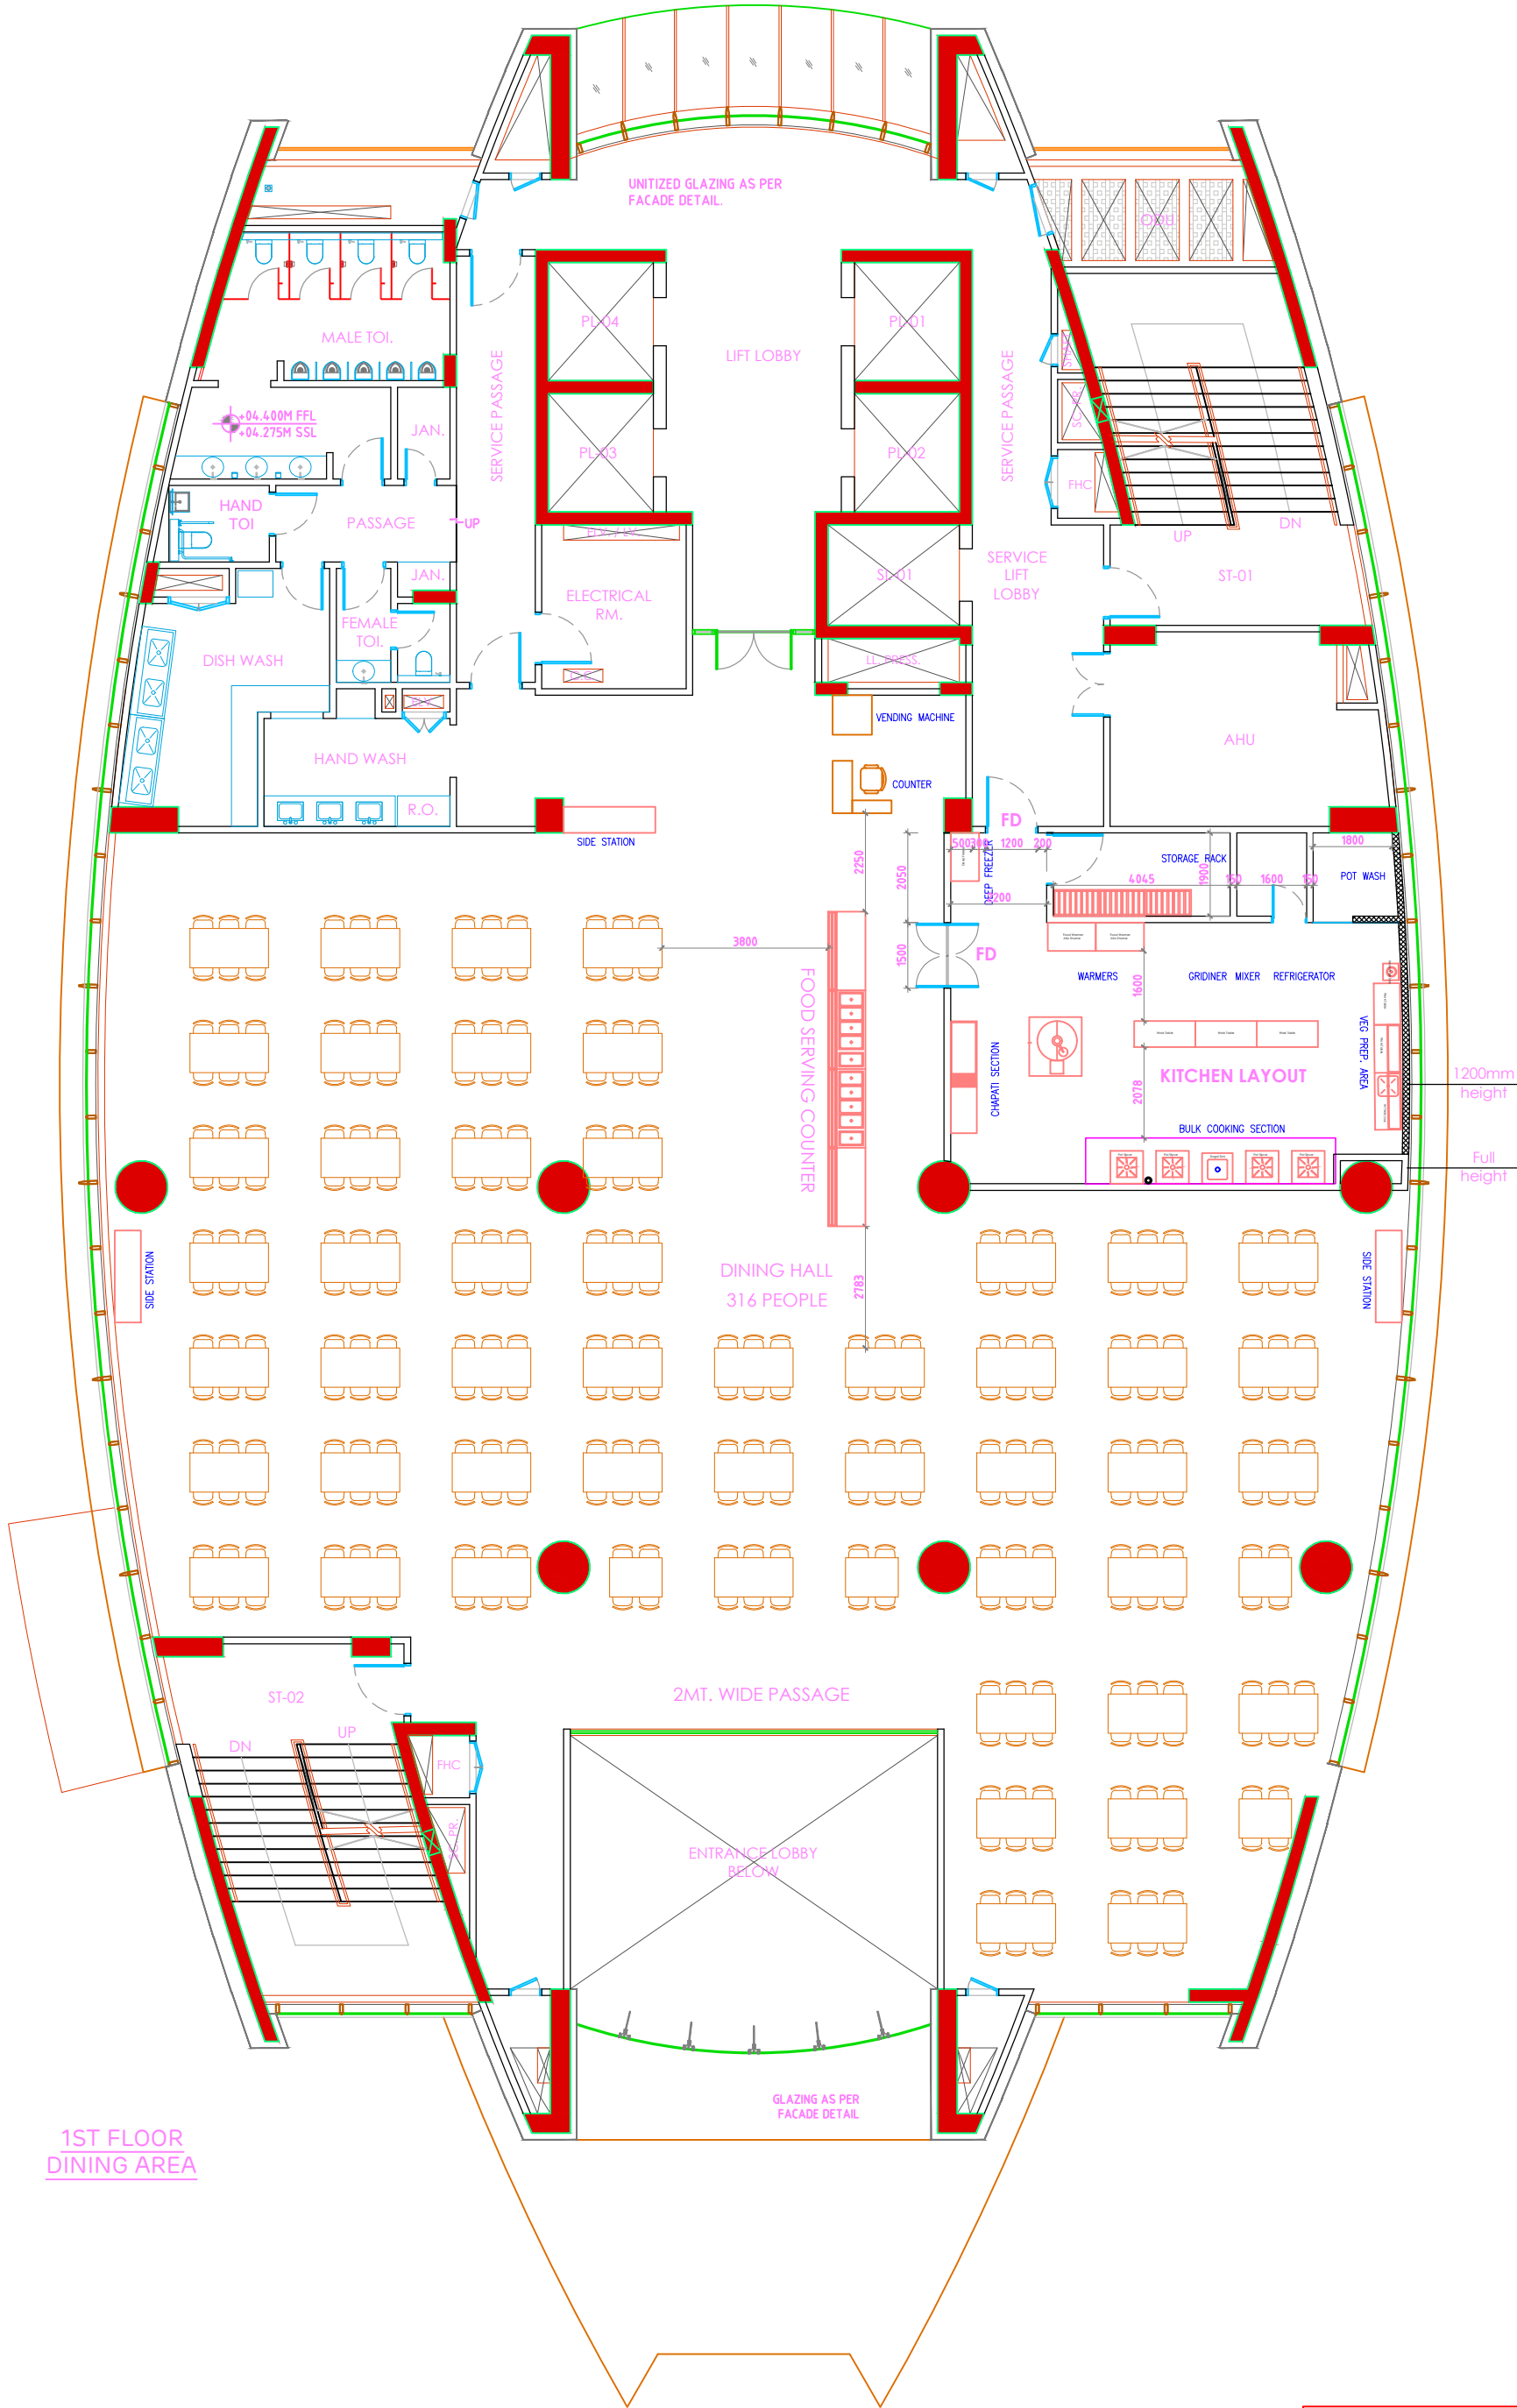

ISSUED FOR INFORMATION

Rev	Description	By	Signed	Date	NOTES :	Client	Drawn	Check	Drawing Title	Client Drawing No.	Consultant Drawing No.	
R0	ISSUED FOR CONSTRUCTION	VM	SN	19-08-2020	NOTES : All dimensions are to be read and not measured. All dimensions are in Millimeters. Refer detail drawings wherever relevant. Drip mould should be provided in lintels of all external openings. R.W.P. indicates rain water pipe. In case there is any discrepancy between architectural drawings and other consultant drawings, architectural drawings to be followed. The discrepancy to be brought to the notice of the architect before commencement of the work. Kindly refer separate drawings for (MEP) services like plumbing, electrical, & firefighting, structure etc. Kindly refer separate detail drawings for staircase, toilet, kitchen, louvers, door window, glazing and other typical detail. No grade slab will be done in wet area on ground floor.	adani	DEVANG	SUDHISH NAIR	ARAVALLI AT SHANTIGRAM	-	AHD-ARV-01-IN-PL-002	R1
R1	AS BUILT AT SITE	-	-	01-08-2024			Approved		FIRST FLOOR FURNITURE LAYOUT PLAN	-		
-	-	-	-	-								
-	-	-	-	-								
Last Modified :- Aug 01, 2024 - 5:20pm												