
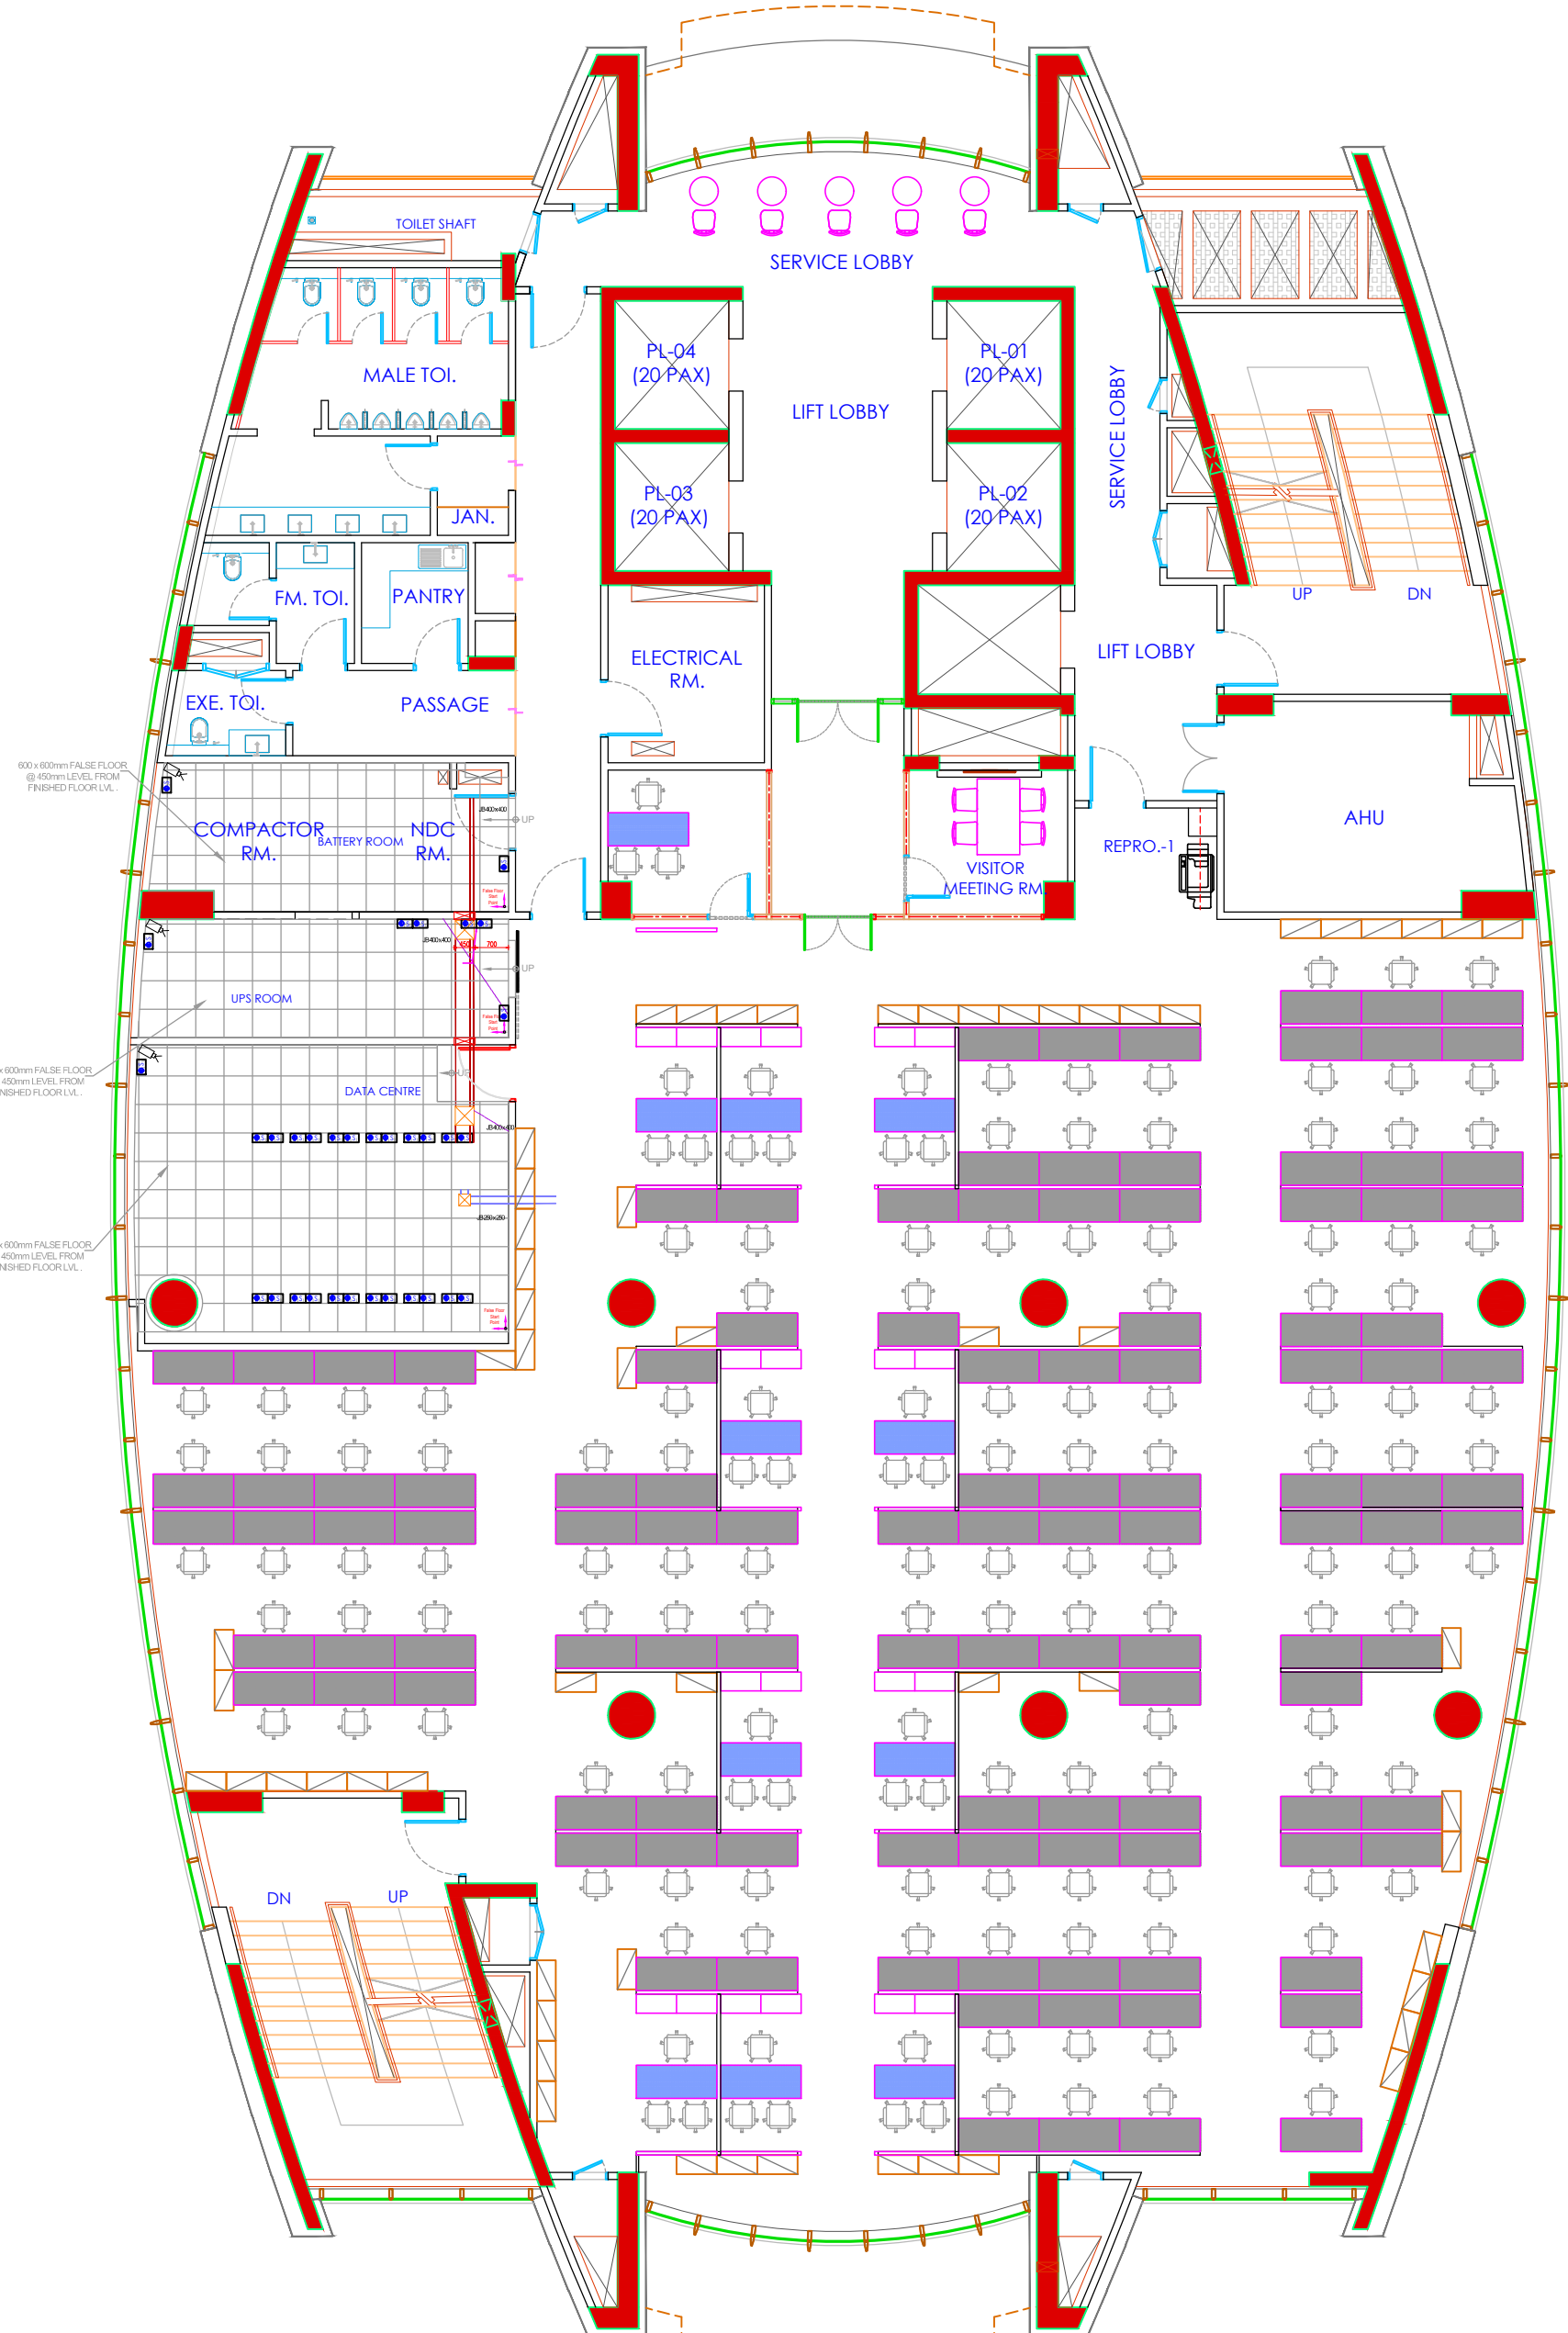 




LEGEND - ARAVALLI							
SR.NO.	DESCRIPTION	EXISTING ABEX OFFICE					
		3RD					
1	CEO CABIN	00					
2	CABIN	01					
3	MANAGER CUBICAL	10					
4	STAFF WORKSTATION	114					
5	MEETING ROOM	00					
6	TRAINING ROOM	00					

	MANAGER CUBICAL(EXISTING)
	STAFF WORKSTATION(EXISTING)
	VP'S CABIN (EXISTING)

ISSUED FOR INFORMATION

Description					By	Signed	Date	NOTES :	Client	Drawn VINODCHANDRA MAKWANA	Check SUDHISH NAIR	Drawing Title	
R0	ISSUED FOR APPROVAL				VM	SN	26-08-2020	All dimensions are to be read and not measured. All dimensions are in Millimeters. Refer detail drawings wherever relevant. Drip mould should be provided in lintels of all external openings. R.W.P. indicates rain water pipe. In case there is any discrepancy between architectural drawings and other consultant drawings, architectural drawings to be followed. The discrepancy to be brought to the notice of the architect before commencement of the work. Kindly refer separate drawings for (M&P) services like plumbing, electrical, fit, firefighting, structure etc. Kindly refer separate detail drawings for staircase, toilet, kitchen, louvers, door window, glazing and other typical detail. No grate slab will be done in wet area on ground floor.		Approved		ARAVALLI AT SHANTIGRAM AT AHMEDABAD 3D FLOOR LAYOUT PLAN PROPOSED OFFICE FOR ADANI THERMAL	
R1	ISSUED FOR APPROVAL				VM	SN	01-09-2020						
R2	ISSUED FOR APPROVAL				VM	SN	09-10-2020						
R3	ISSUED FOR APPROVAL				VM	SN	23-10-2020						
R4	ISSUED FOR APPROVAL				VM	SN	14-12-2020						
R5	AS BUILT AT SITE				-	-	01-08-2024						
-					-	-	-						
-					-	-	-						
-					-	-	-						
-					-	-	-						
Last Modified :- Aug 01, 2024 - 5:16pm													
													R5