


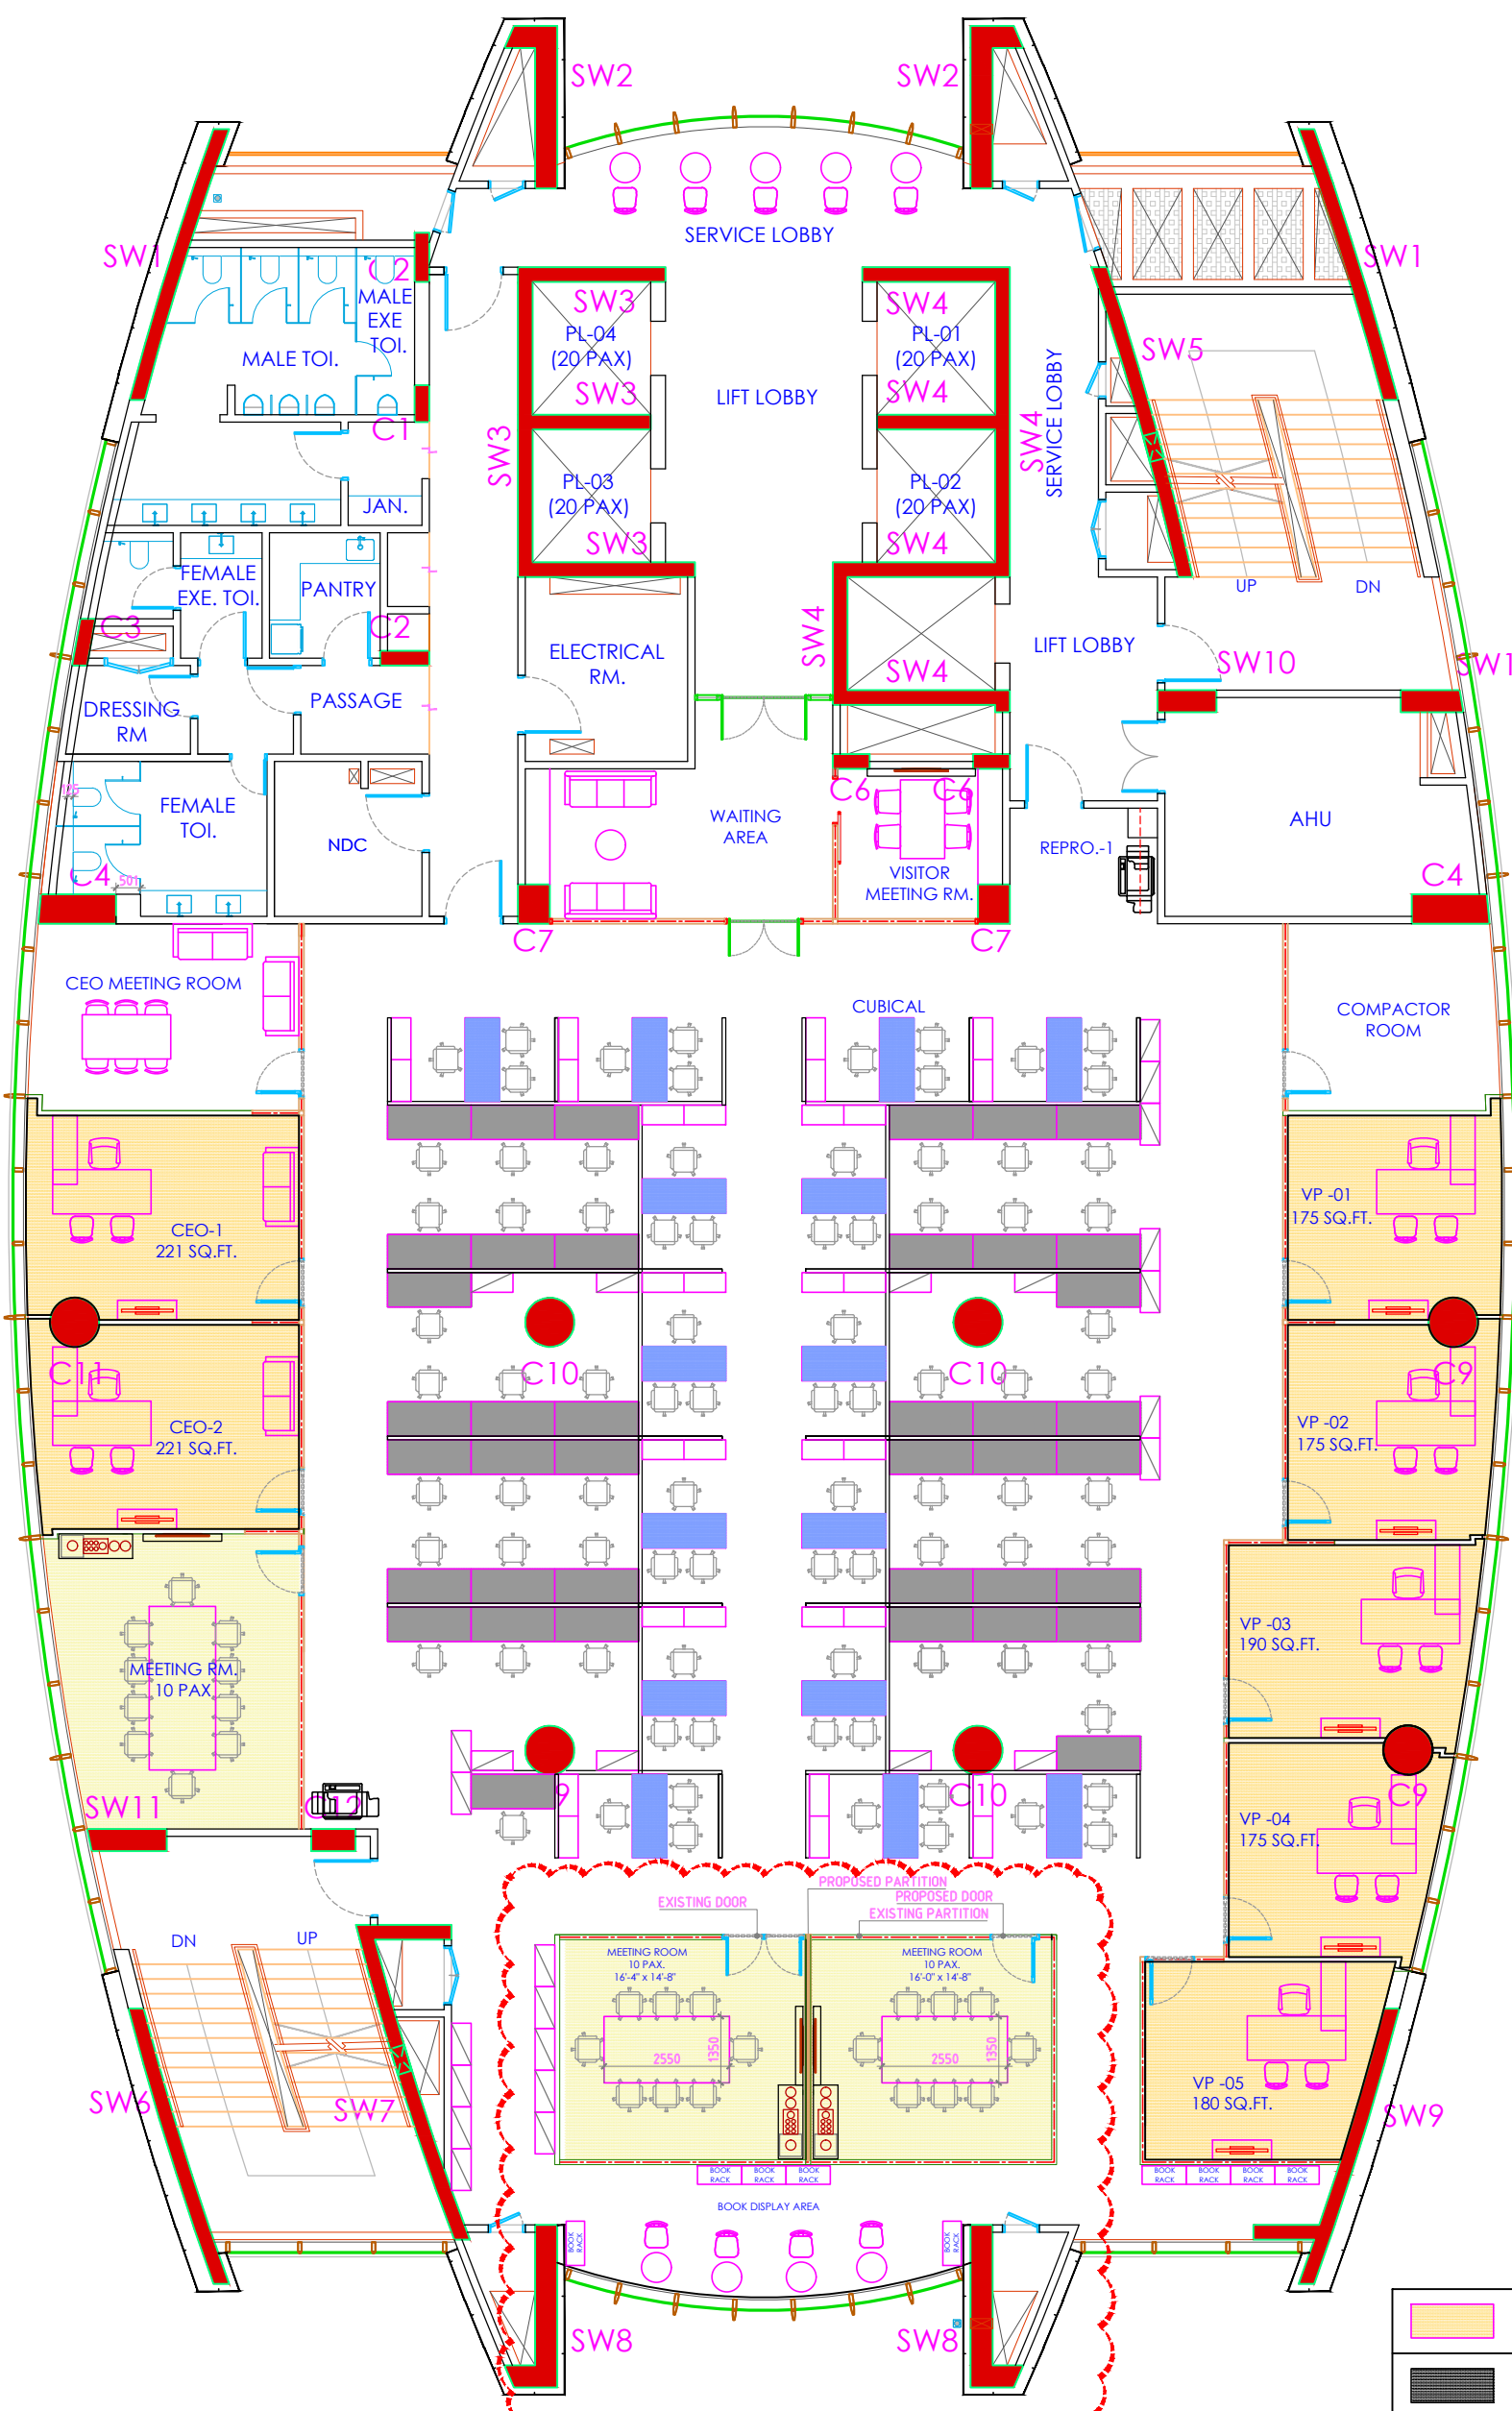

LEGEND - ARAVALLI					
SR.NO.	DESCRIPTION	ADANI FOUNDATION			
		7TH			
1	CEO CABIN	02			
2	VP CABIN	05			
3	MANAGER CUBICAL	15			
4	STAFF WORKSTATION	40			
5	MEETING ROOM	03			
6	TRAINING ROOM	00			

	VP CABIN
	CEO CABIN
	MANAGER CUBICAL
	STAFF WORKSTATION
	MEETING ROOM

ISSUED FOR INFORMATION

Rev	Description	By	Signed	Date
R0	ISSUED FOR APPROVAL	VM	SN	05-04-2024
R0	ISSUED FOR INTERIOR	VM	SN	17-04-2024
R1	AS BUILT AT SITE	-	-	01-08-2024

Last Modified :- Aug 01, 2024 - 5:04pm

NOTES :

All dimensions are to be read and not measured.

W.P. indicates rain water pipe.

Refer detail drawings wherever relevant.

Drip mould should be provided in lintels of all external openings.

In case there is any discrepancy between architectural drawings and other consultant drawings, architectural drawings to be followed.

The discrepancy to be brought to the notice of the architect before commencement of the work.

Kindly refer separate drawings for (MEP) services like plumbing, electrical, fire fighting, structure etc.

Kindly refer separate detail drawings for staircase, toilet, kitchen, lavatory, door window, glazing and other typical detail.

No grade slab will be done in wet area on ground floor.

Client

Drawn	VINODCHANDRA MAKWANA	Check	SUDHISH NAIR
Approved			

Drawing Title

ARAVALLI AT SHANTIGRAM

ADANI FOUNDATION OFFICE

7TH FLOOR LAYOUT PLAN

Client Drawing No. -

Consultant Drawing No. AHD-ARV-07-IN-PL-007

R1