


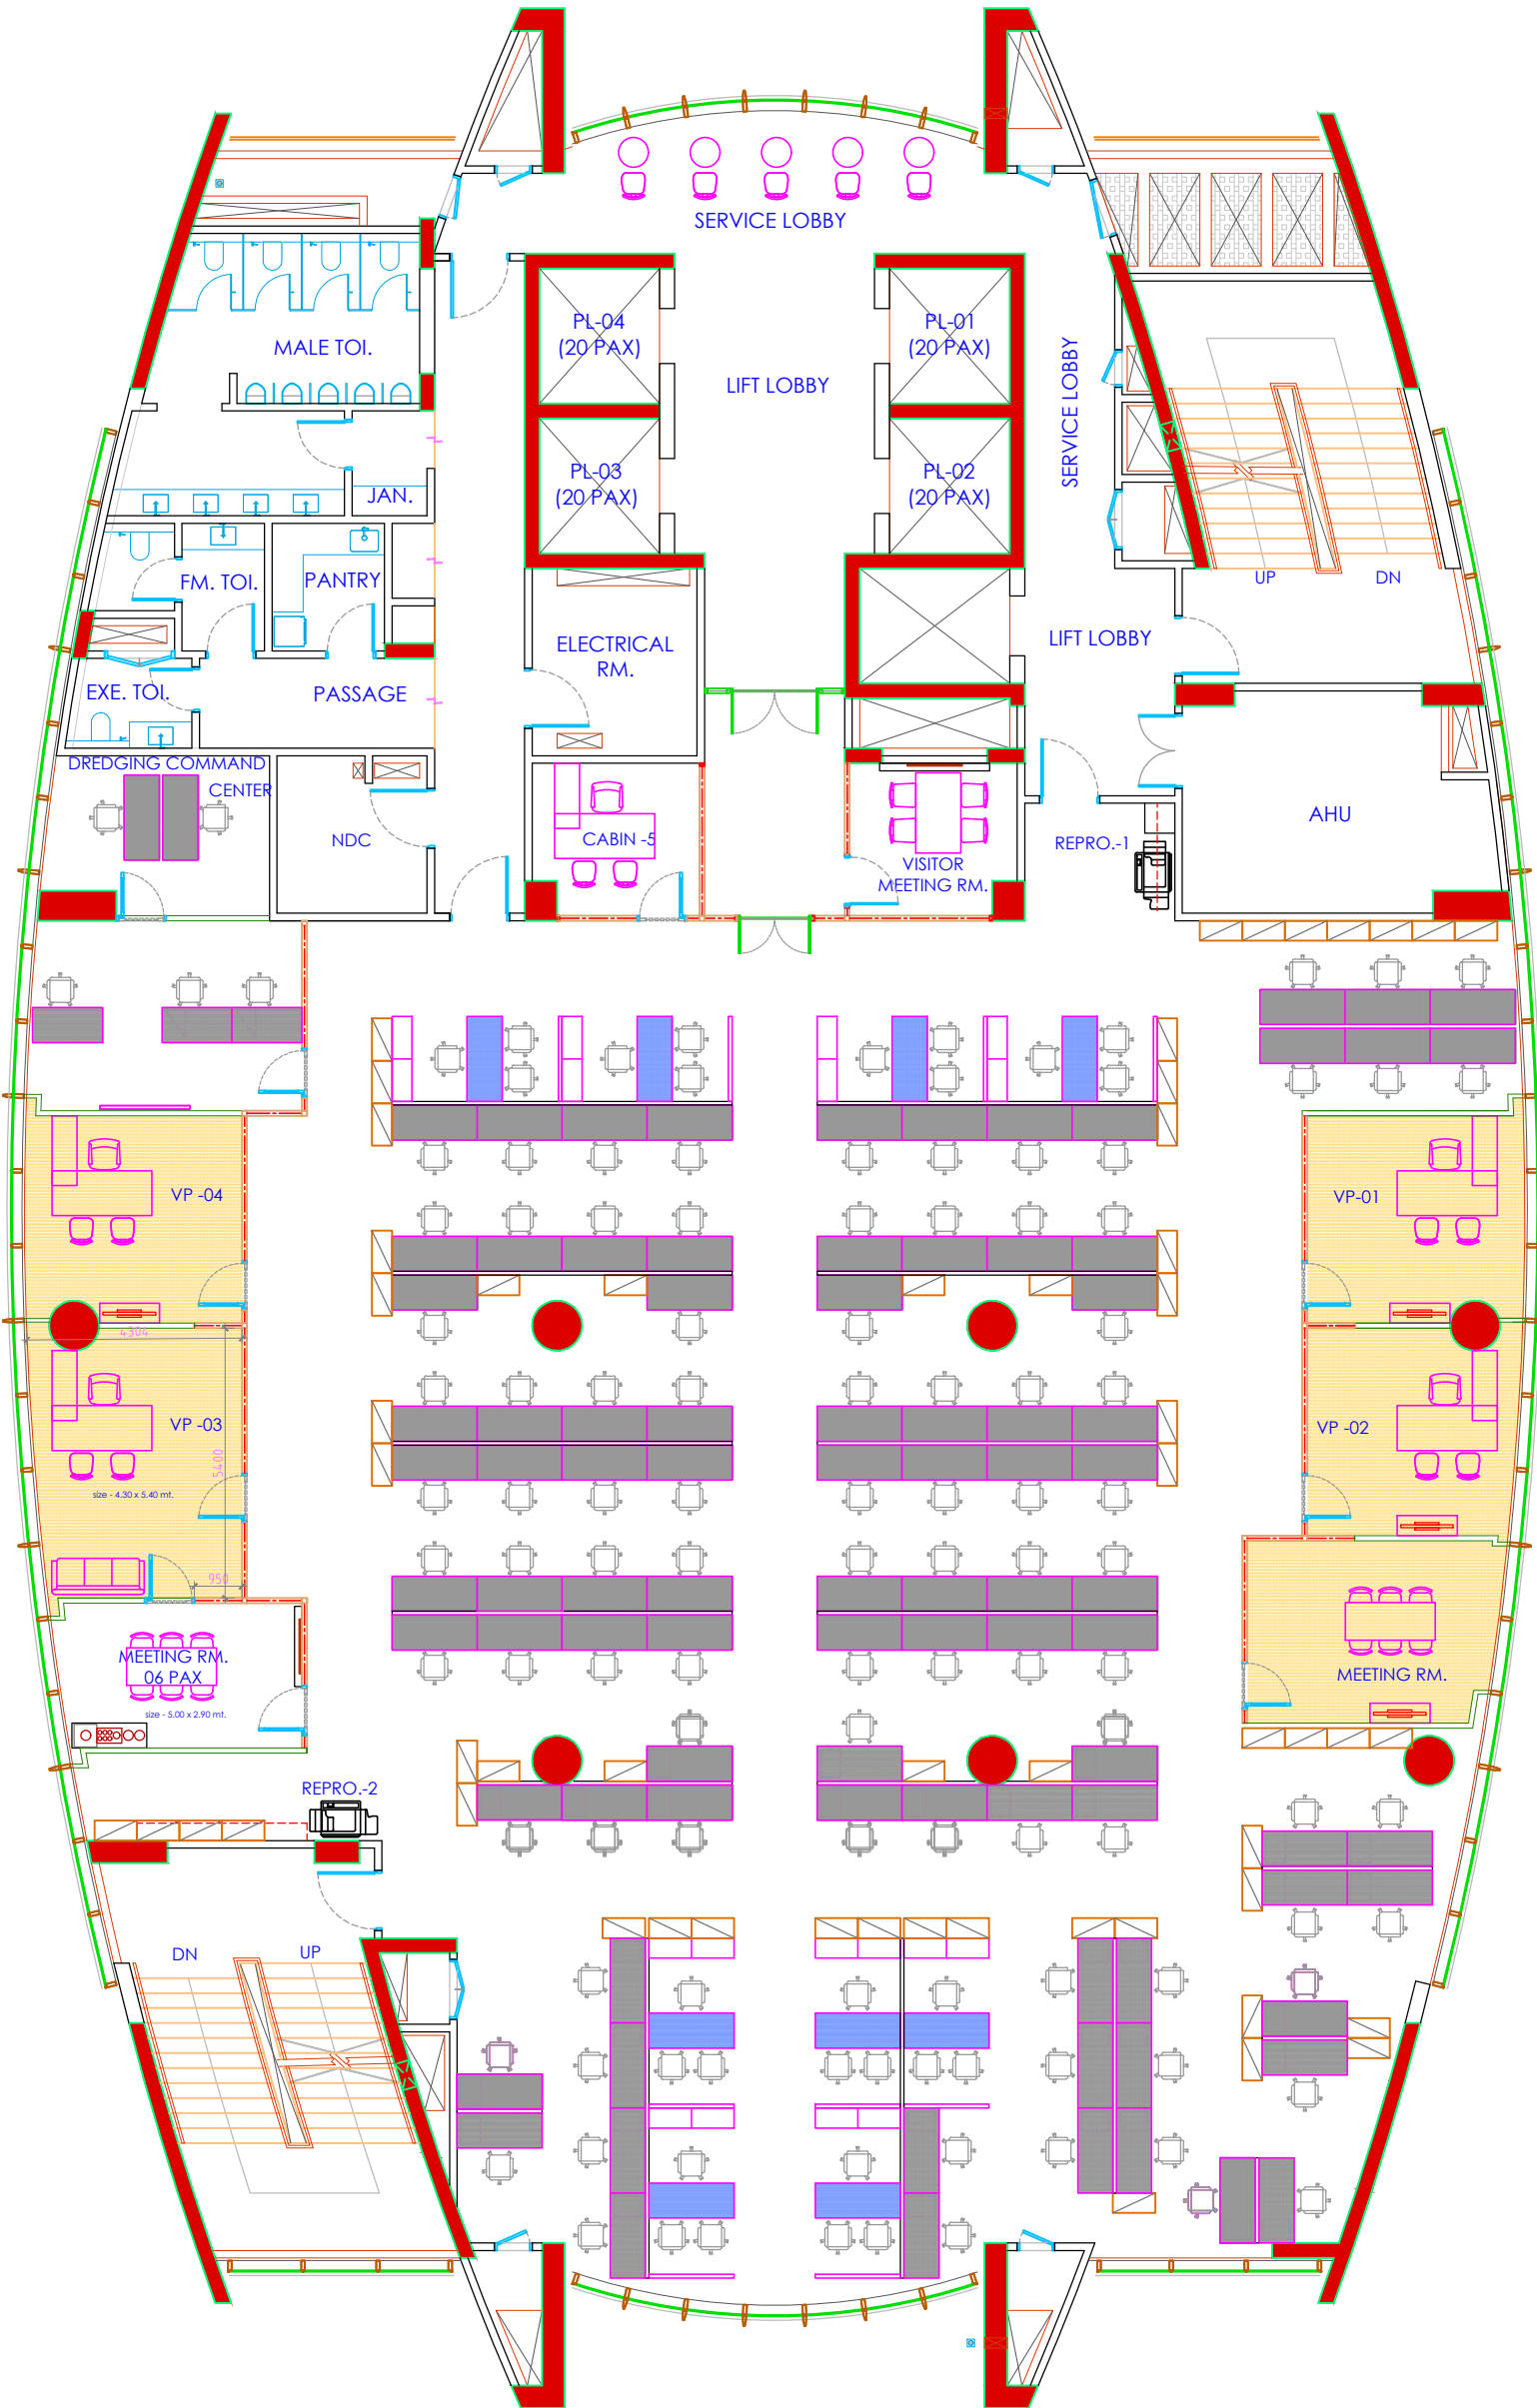

LEGEND - ARAVALLI EXISTING APSEZ- DREGING AND IT OFFICE					
SR.NO.	DESCRIPTION	FUTURE BUSINESS OFFICE			
		10TH			
1	CEO CABIN	00			
2	VP CABIN	05			
3	MANAGER CUBICAL	09			
4	STAFF WORKSTATION	95			
5	MEETING ROOM	02			
6	TRAINING ROOM	00			

10TH FLOOR
FUTURE BUSINESS
OFFICE

	MANAGER CUBICAL(EXISTING)
	STAFF WORKSTATION(EXISTING)
	VP'S CABIN (EXISTING)

ISSUED FOR INFORMATION

Rev	Description	By	Signed	Date
R0	ISSUED FOR APPROVAL	VM	SN	26-08-2020
R1	ISSUED FOR APPROVAL	VM	SN	01-09-2020
R2	ISSUED FOR APPROVAL	VM	SN	09-10-2020
R3	ISSUED FOR APPROVAL	VM	SN	23-10-2020
R4	AS BUILT AT SITE	-	-	01-08-2024

NOTES :

All dimensions are to be read and not measured.
All dimensions are in Millimeters.
Refer detail drawings wherever relevant.
Drip mould should be provided in lintels of all external openings.
R.W.P. indicates rain water pipe.
In case there is any discrepancy between architectural drawings and other consultant drawings, architectural drawings to be followed.
The discrepancy to be brought to the notice of the architect before commencement of the work.
Kindly refer separate drawings for (MEP)services like plumbing, electrical, fire fighting, structure etc.
Kindly refer separate detail drawings for staircase, toilet, kitchen, louvers, door window, glazing and other typical detail.
No grade slab will be done in wet area on ground floor.

Client

Drawn	Check
VINODCHANDRA MAKWANA	SUDHISH NAIR
Approved	

Drawing Title

ARAVALI AT SHANTIGRAM
AT AHMEDABAD
10TH FLOOR LAYOUT PLAN
PROPOSED FUTURE BUSINESS OFFICE

Client Drawing No.	Consultant Drawing No.
-	AHD-ARV-SHT-IN-PL-010

Last Modified :- Aug 01, 2024 - 5:08pm

H G F E D C B A

12

R4