


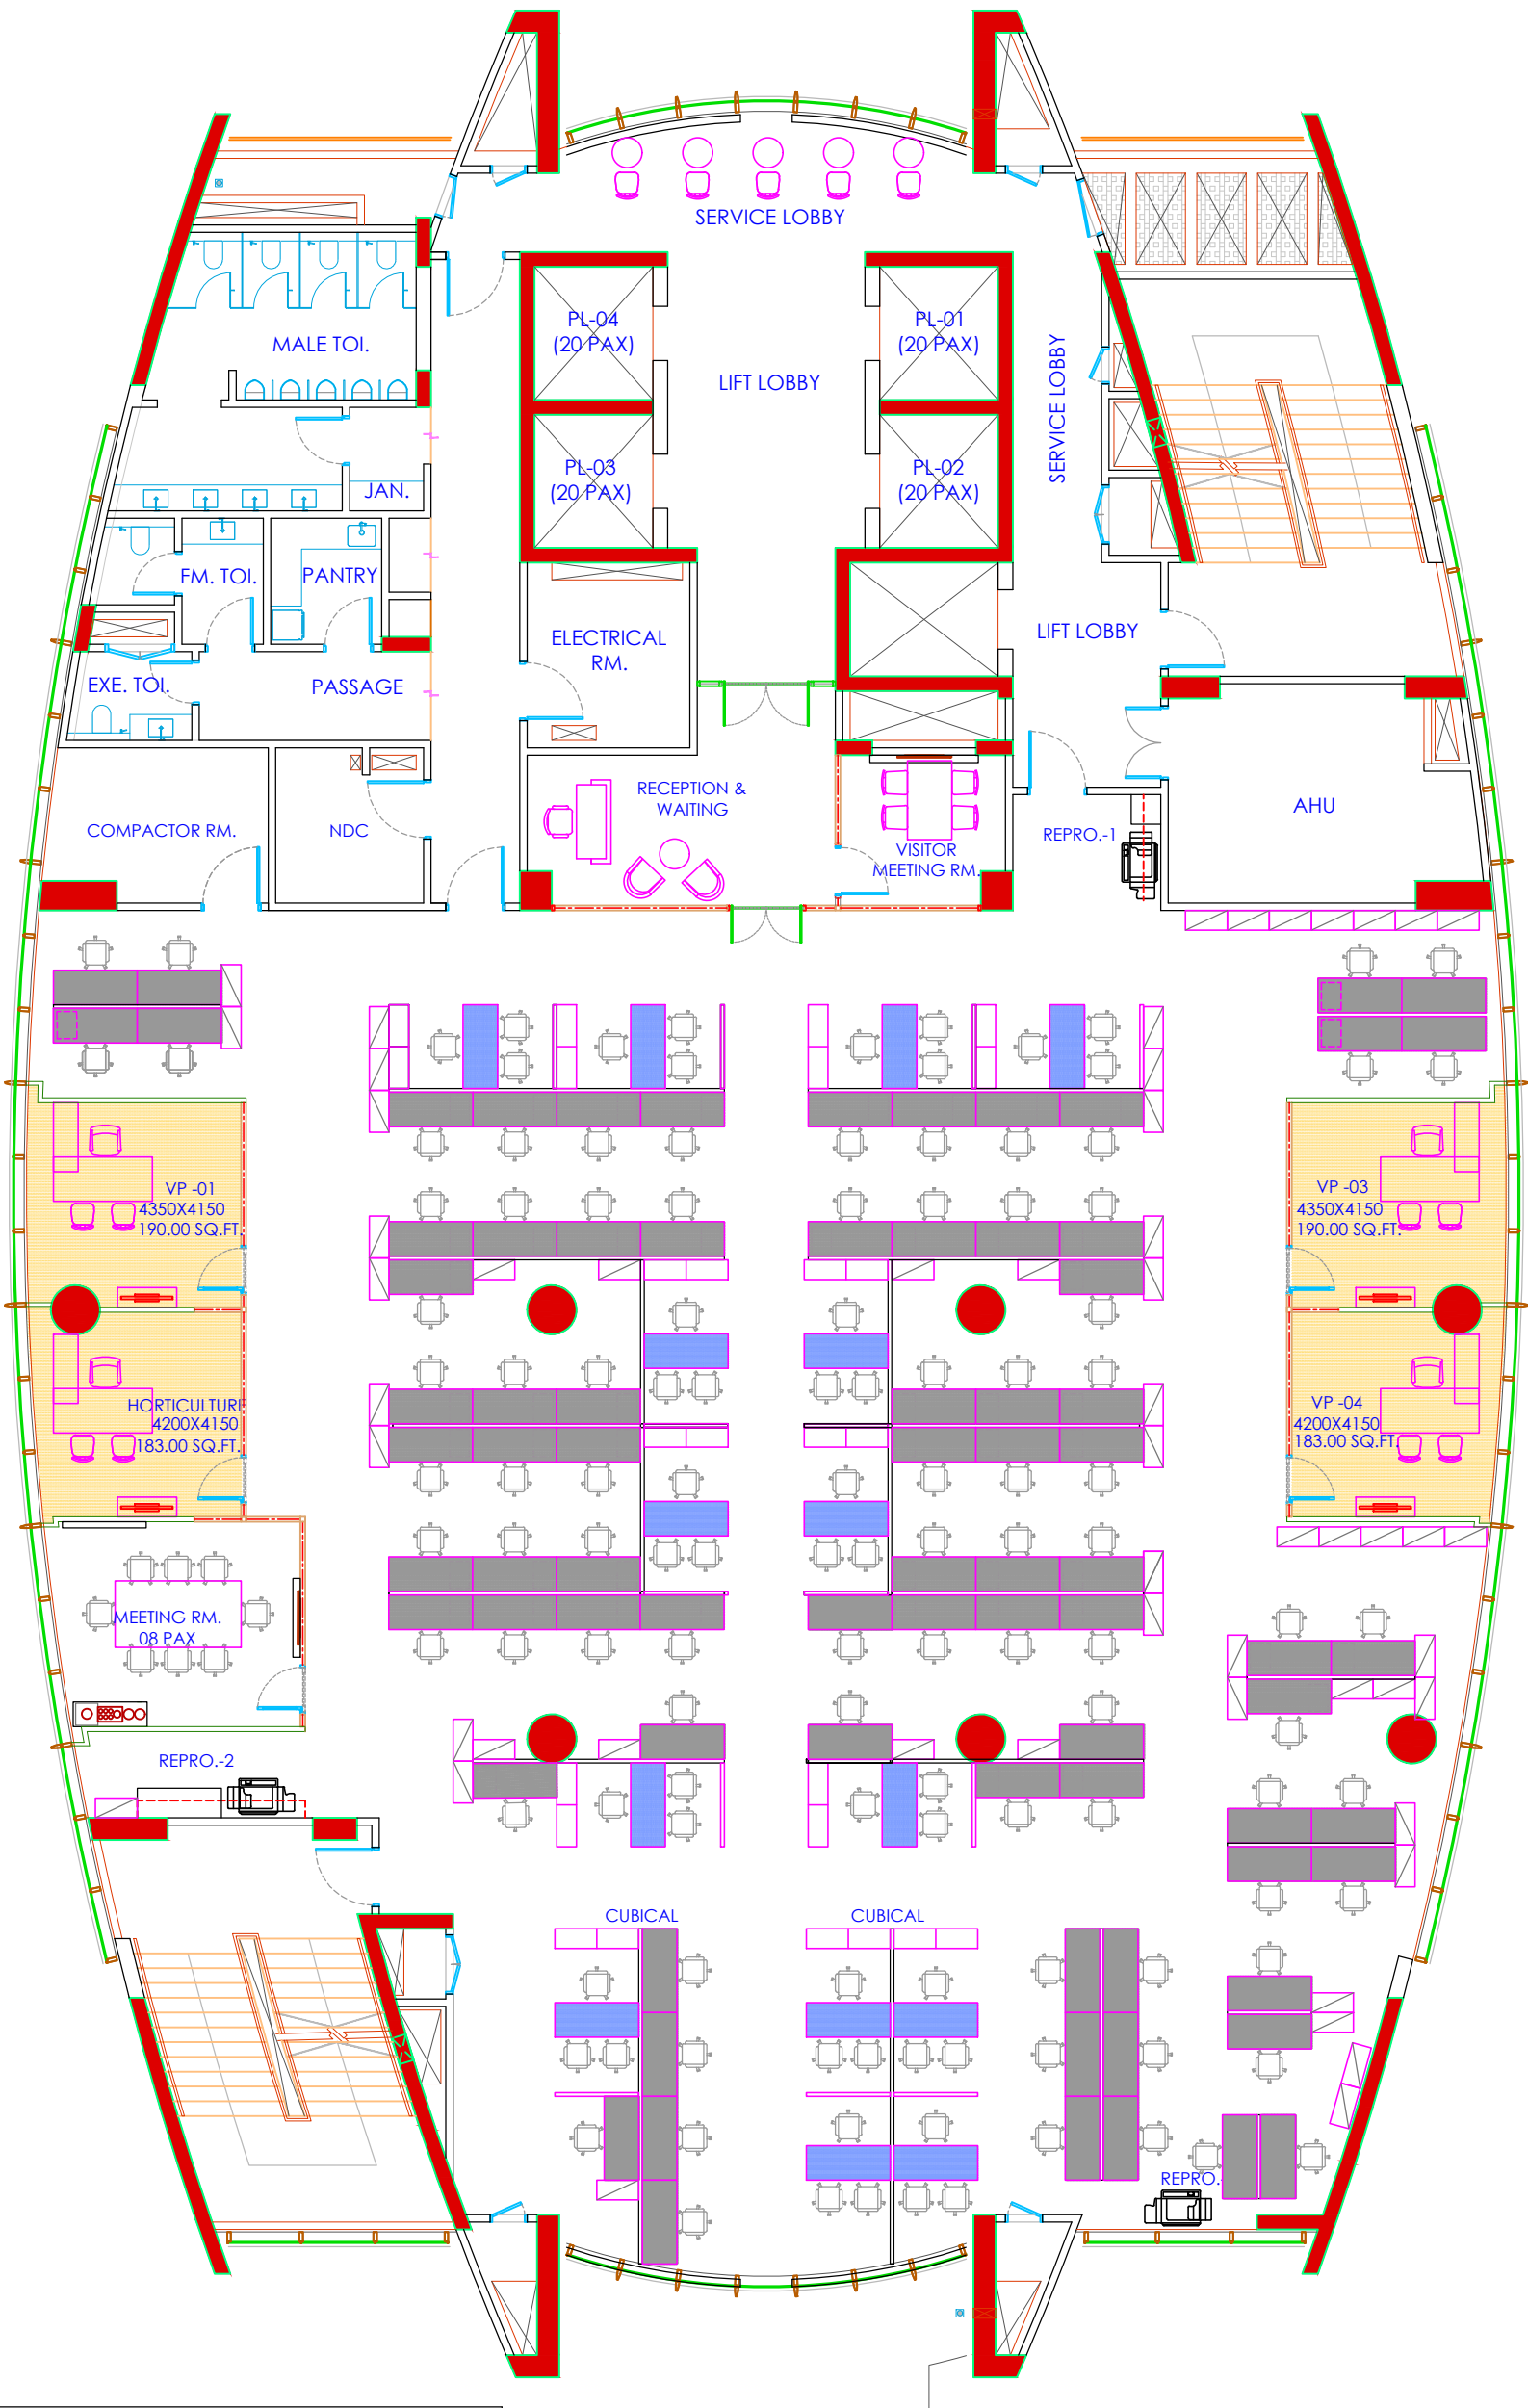

LEGEND - ARAVALLI

		FUTURE BUSINESS OFFICE			
SR.NO	DESCRIPTION	12TH			
1	CEO CABIN	00			
2	VP CABIN	04			
3	MANAGER CUBICAL	15			
4	STAFF WORKSTATION	80			
5	MEETING ROOM	01			
6					

12TH FLOOR
FUTURE BUSINESS
OFFICE

	MANAGER CUBICAL(EXISTING)
	STAFF WORKSTATION(EXISTING)
	VP'S CABIN (EXISTING)

ISSUED FOR INFORMATION

Rev	Description	By	Signed	Date	NOTES :
R0	ISSUED FOR APPROVAL	VM	SN	26-08-2020	All dimensions are to be read and not measured. All dimensions are in Millimeters. Refer detail drawings wherever relevant. Drip mould should be provided in lintels of all external openings. R.W.P. indicates rain water pipe. In case there is any discrepancy between architectural drawings and other consultant drawings, architectural drawings to be followed. The discrepancy to be brought to the notice of the architect before commencement of the work. Kindly refer separate drawings for (MEP)services like plumbing, electrical, & firefighting, structure etc. Kindly refer separate detail drawings for staircase, toilet, kitchen, louvers, door window, glazing and other typical detail. No grade slab will be done in wet area on ground floor.
R1	ISSUED FOR APPROVAL	VM	SN	01-09-2020	
R2	ISSUED FOR APPROVAL	VM	SN	09-10-2020	
R3	ISSUED FOR APPROVAL	VM	SN	23-10-2020	
R4	AS BUILT AT SITE	-	-	01-08-2024	
-		-	-	-	
-		-	-	-	
Last Modified :- Aug 01, 2024 - 5:08pm

Client		Drawn	Check	Drawing Title	
		VINODCHANDRA MAKWANA	SUDHISH NAIR	ARAVALI AT SHANTIGRAM AT AHMEDABAD 12TH FLOOR LAYOUT PLAN PROPOSED FUTURE BUSINESS OFFICE	
		Approved			
		Client Drawing No.		Consultant Drawing No.	
		-		AHD-ARV-SHT-IN-PL-012	

R4